



BK 27474 PG 069



**DIAGRAM KEY**

- Red Line:** Existing chainlink fence.
- Black Line:** Existing wooden fence.
- Green:** Existing Garden area.
- Orange:** Mulch pile area.
- Blue:** Rain barrel system.

ANNE ARUNDEL COUNTY CLERK'S OFFICE Land and Records: 380 27474, P. 0199, MSA, CES9, 2014, Date available: 07/28/2014, E-mail: 401/12/2014

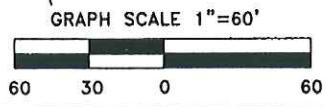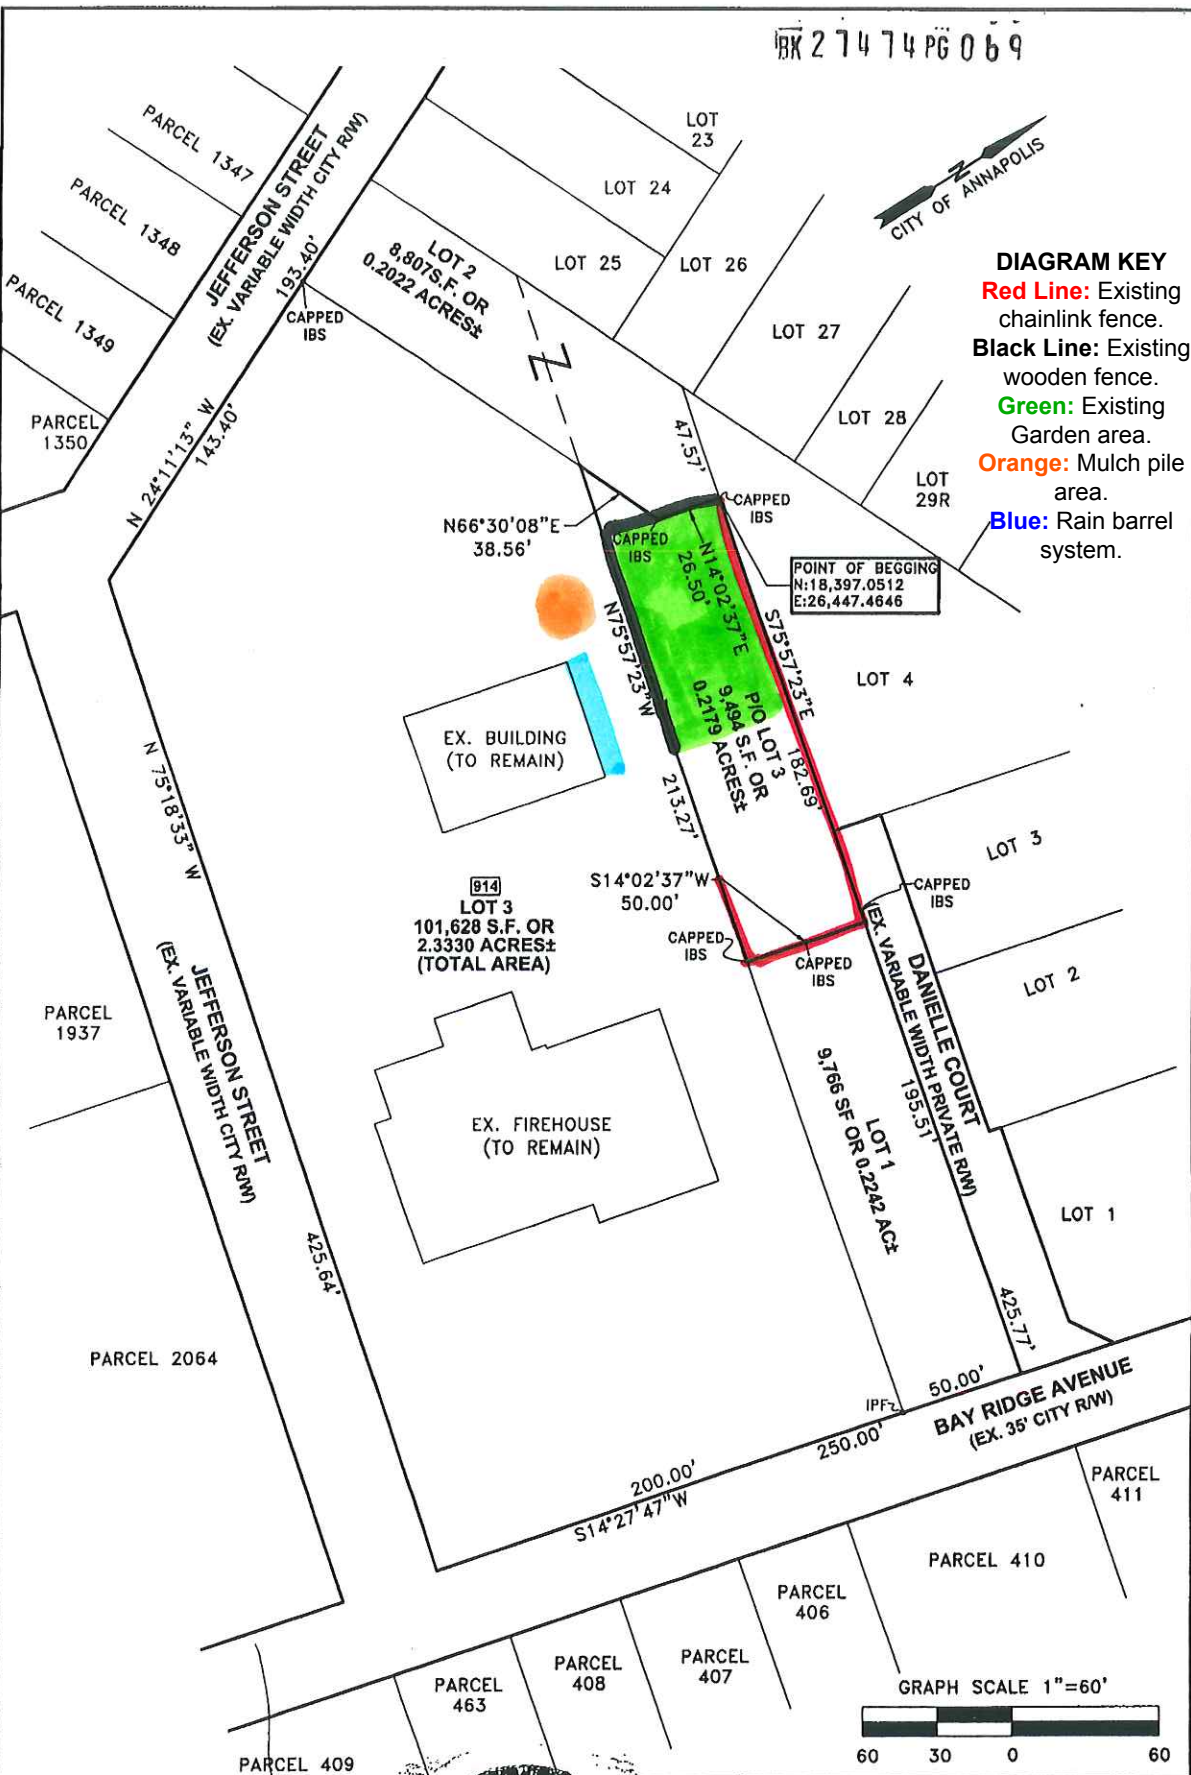

**TERRAIN, INC.**  
 ENGINEERING AND  
 DEVELOPMENT SERVICES  
 106 OLD SOLOMONS ISLAND RD  
 ANNAPOLIS, MD 21401  
 PH (410) 266-1160  
 FAX (410) 266-6129



**EXHIBIT SHOWING**  
 9,494 SF OR 0.2179 ACRES±  
 PART OF LIBER 9749 FOLIO 612  
 TAX MAP 52D, GRID 14, PARCEL 1462  
 SIXTH TAX DISTRICT  
 ANNE ARUNDEL CO., MARYLAND 21403  
 SCALE: 1"=60' MARCH, 2014